



SIDE VIEW




(AS-BUILT)

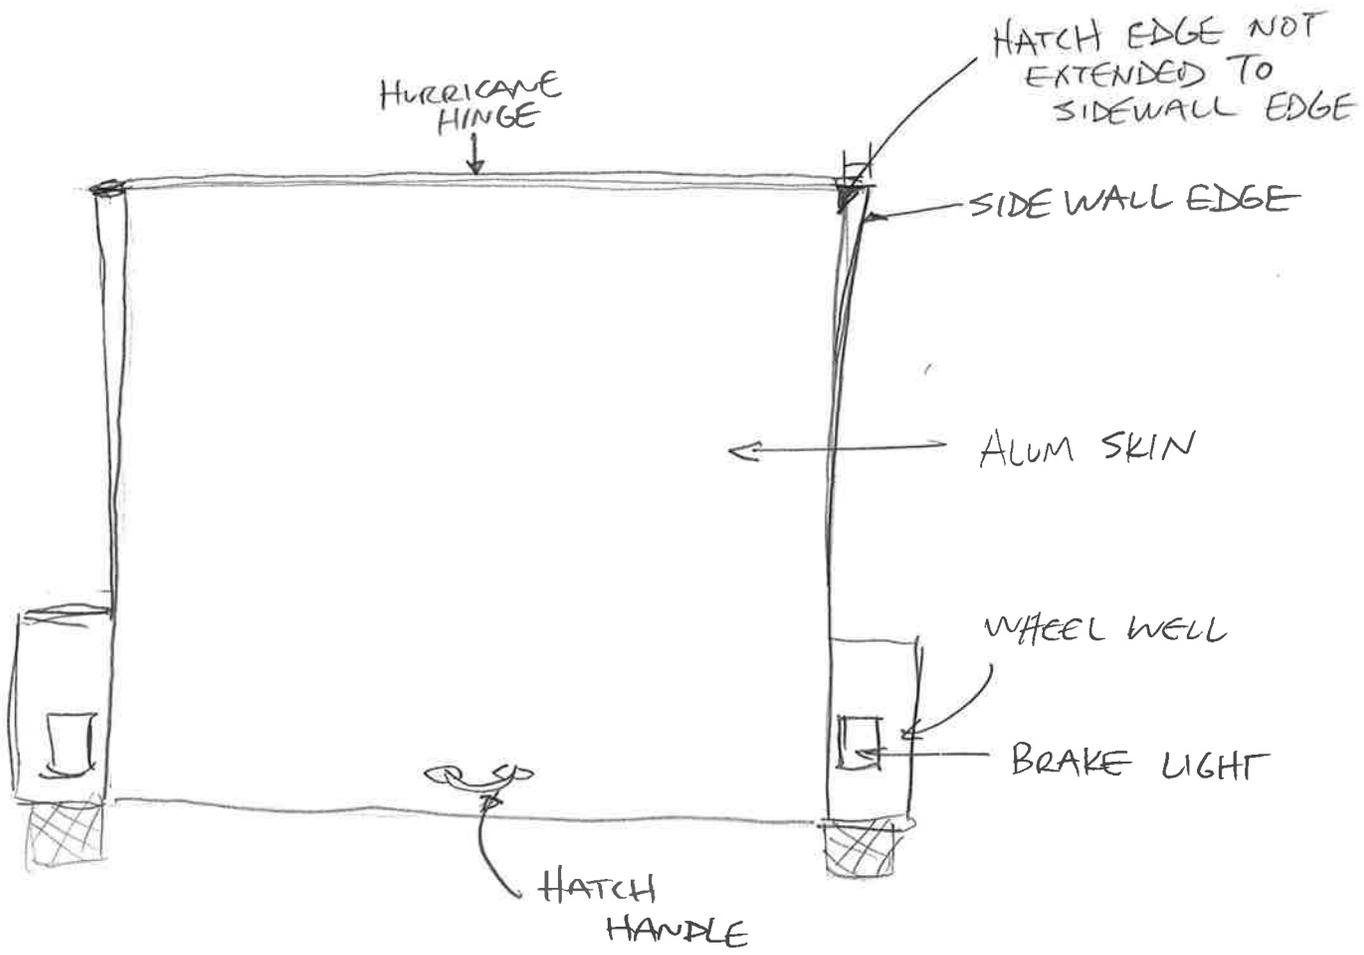


BACK VIEW  
(AS-BUILT)

# GALLEY HATCH

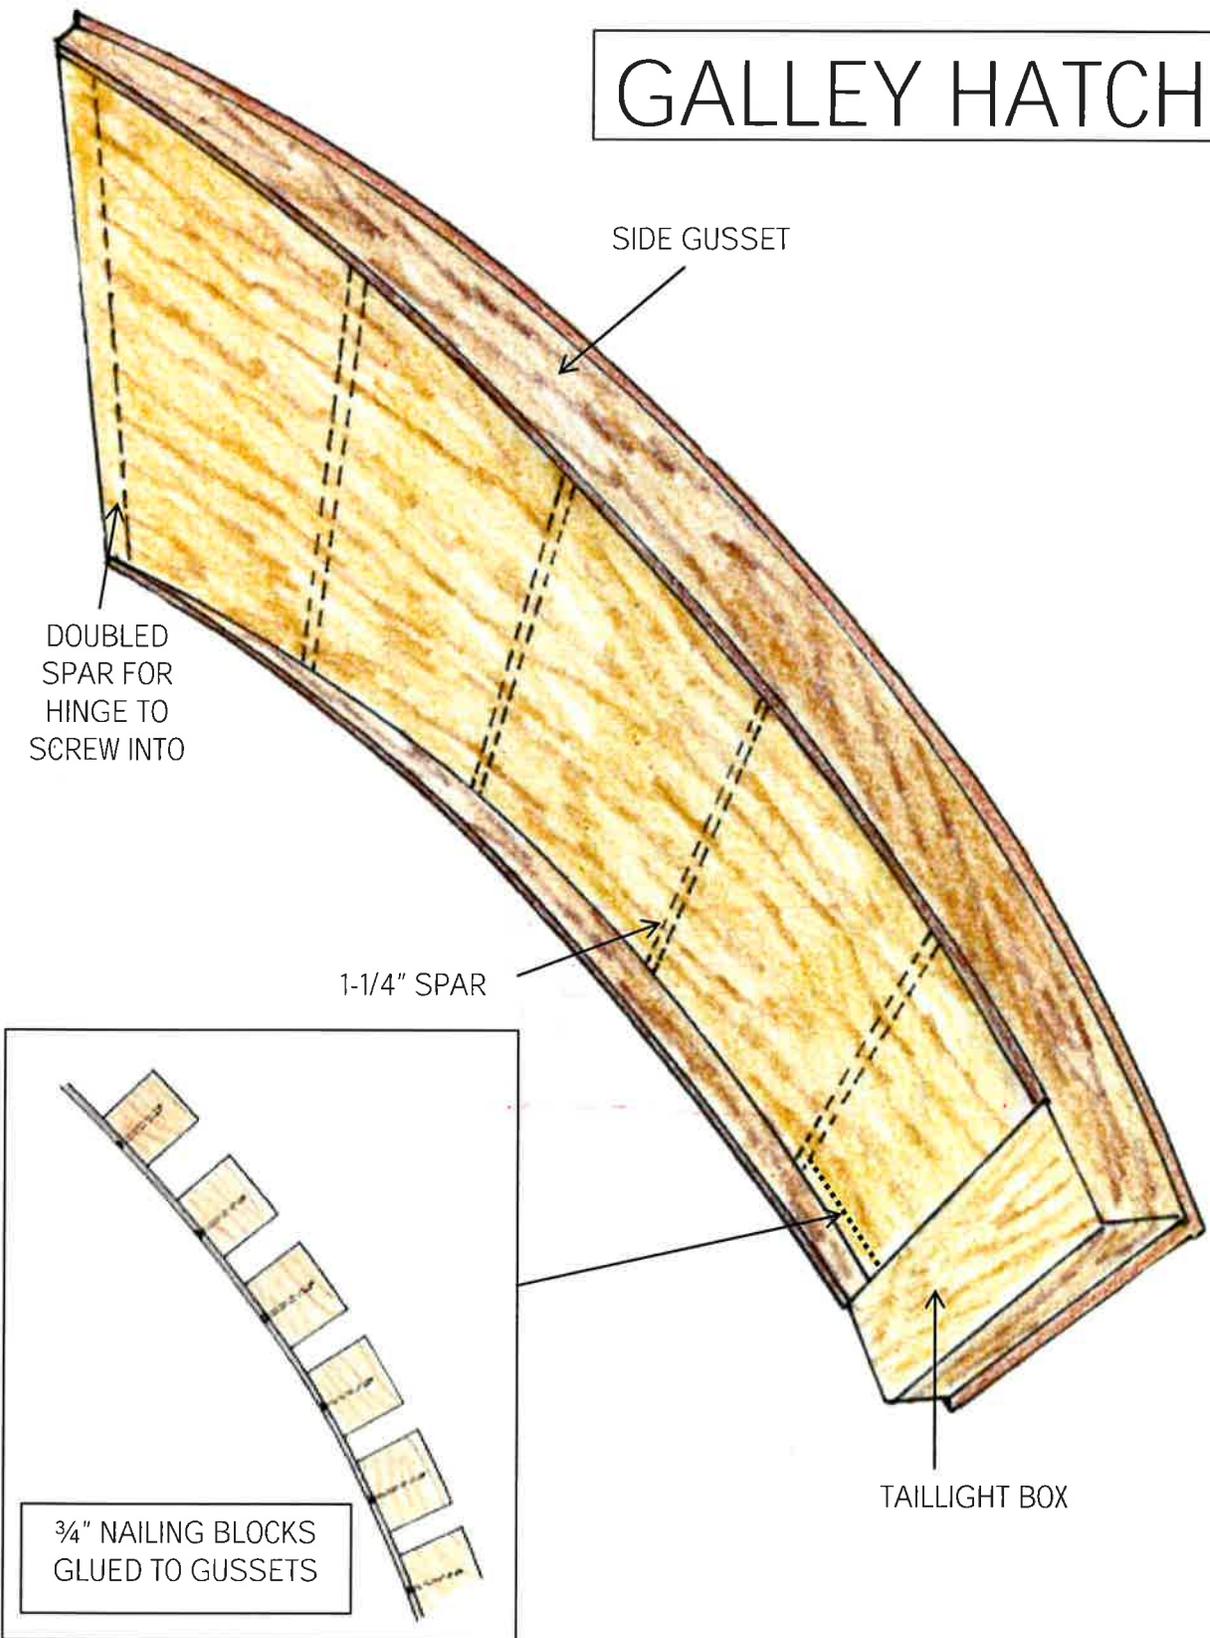

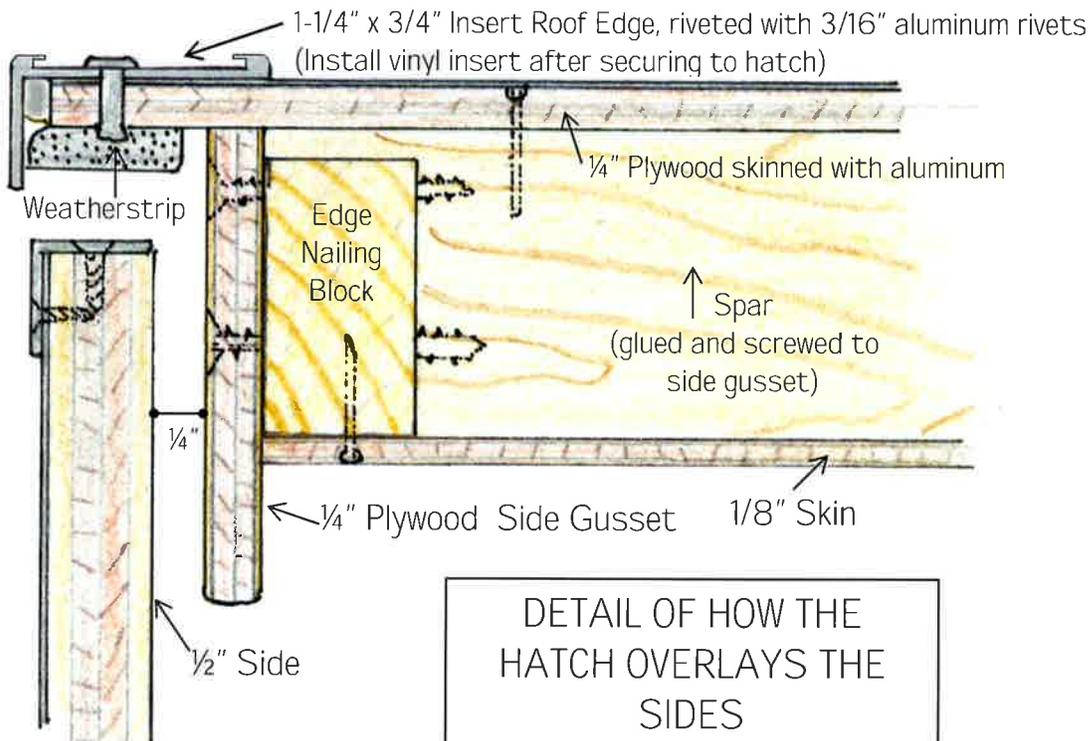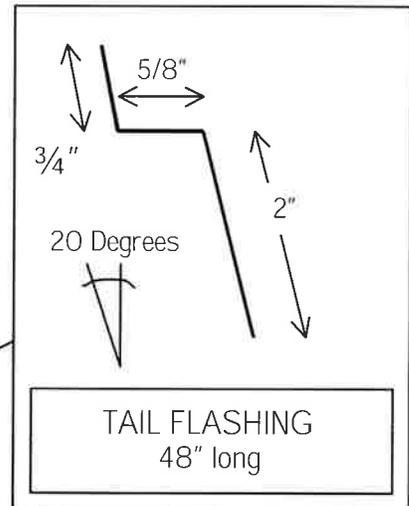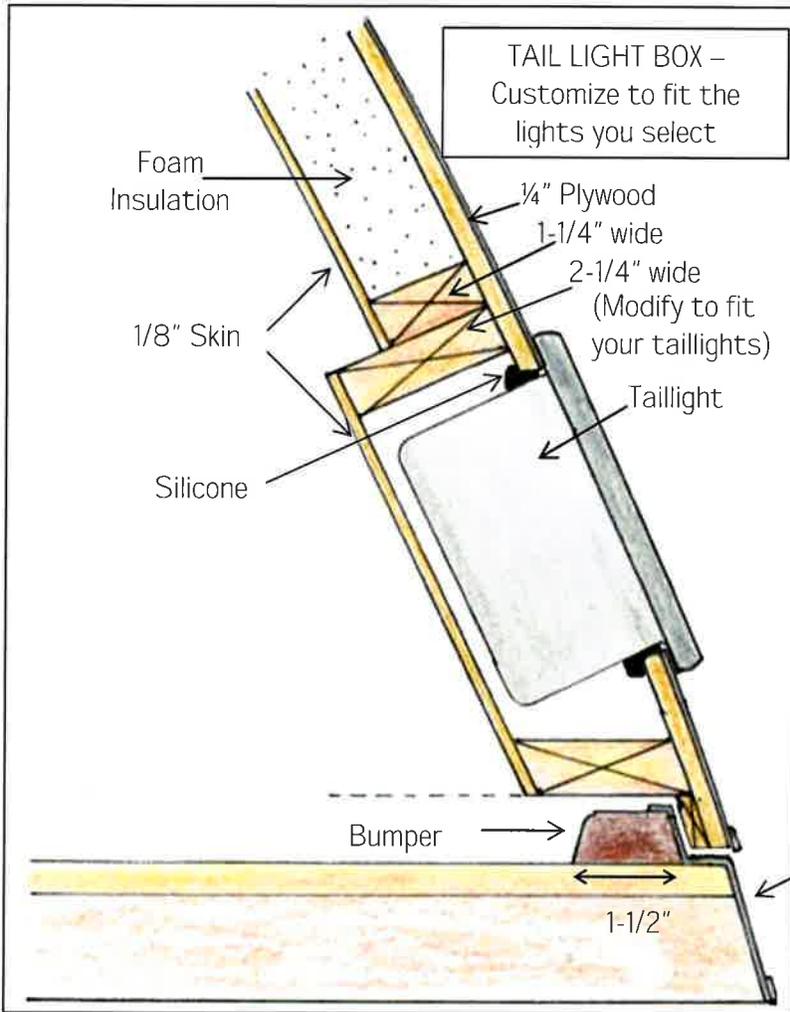

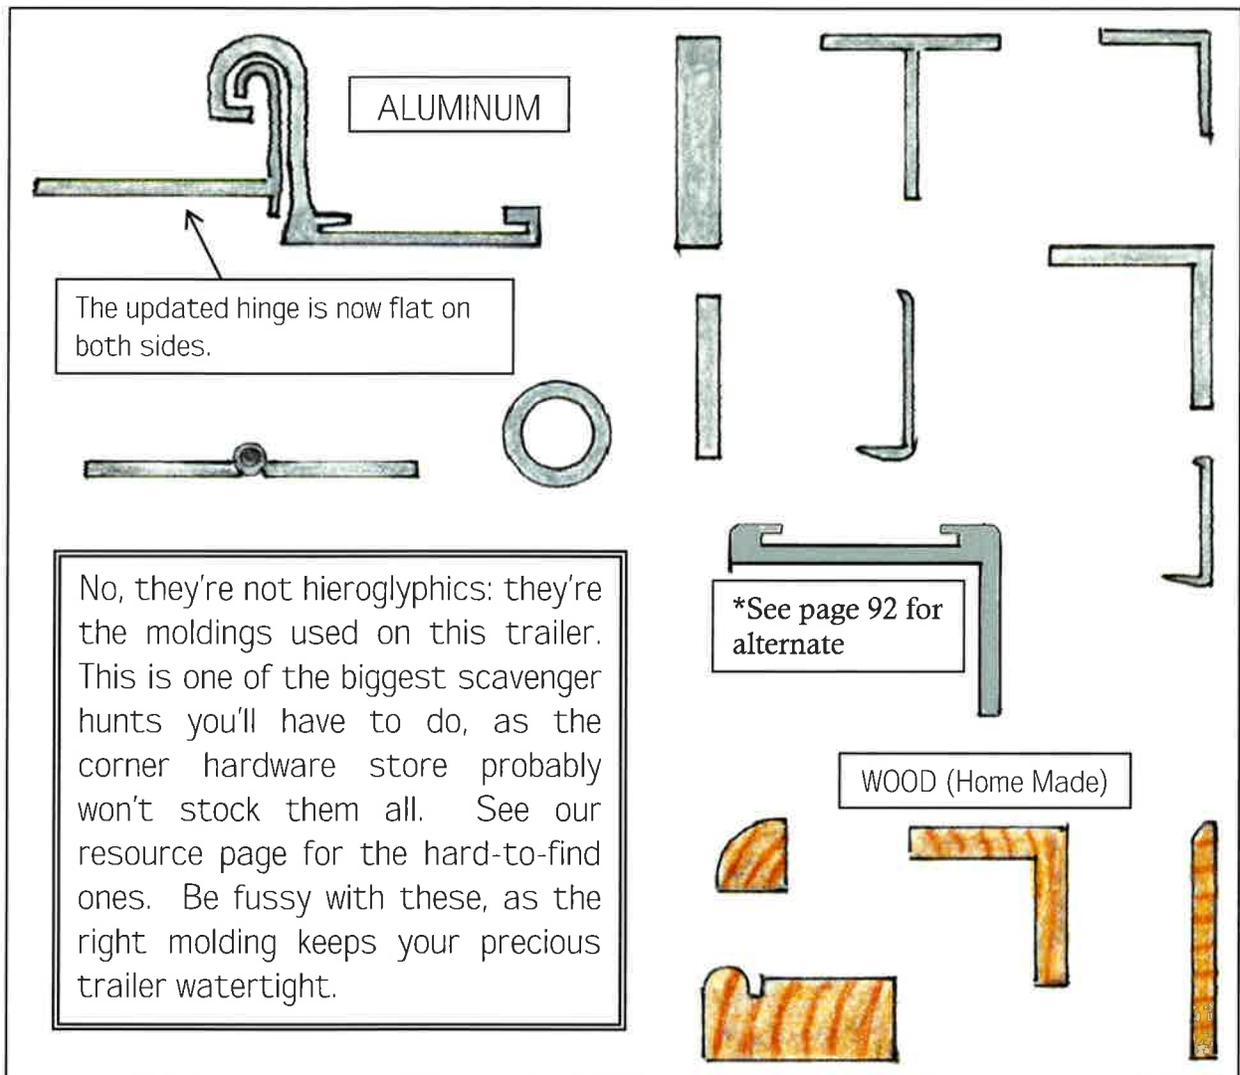

**-ALUMINUM-**

**Top**, left to right: "Hurricane Hinge,  $\frac{1}{4}$ " x  $\frac{3}{4}$ " Flat Bar, Tee Moulding,  $\frac{1}{2}$ " Angle.

**Middle**. Stainless Continuous Hinge,  $\frac{1}{2}$ " O.D. Tubing,  $\frac{1}{8}$ " x  $\frac{3}{4}$ " Flat Bar,  $\frac{3}{4}$ " "J" moulding,  $\frac{3}{4}$ " Angle.

**Bottom**.  $1\text{-}\frac{1}{4}$ " x  $\frac{3}{4}$ " Insert Roof Edge\*,  $\frac{1}{2}$ " "J" Moulding

**-WOOD-**

$\frac{3}{8}$ " Quarter-Round,  $\frac{3}{4}$ " Angle,  $1\text{-}\frac{1}{8}$ " x  $\frac{1}{8}$ " Flat,  $\frac{3}{8}$ " x  $\frac{3}{4}$ " Countertop Edge